


roved 8/10/78, subject to:
veway must be blacktopped
October 1, 1978.

William P. Horton
William P. Horton
E. of Highways

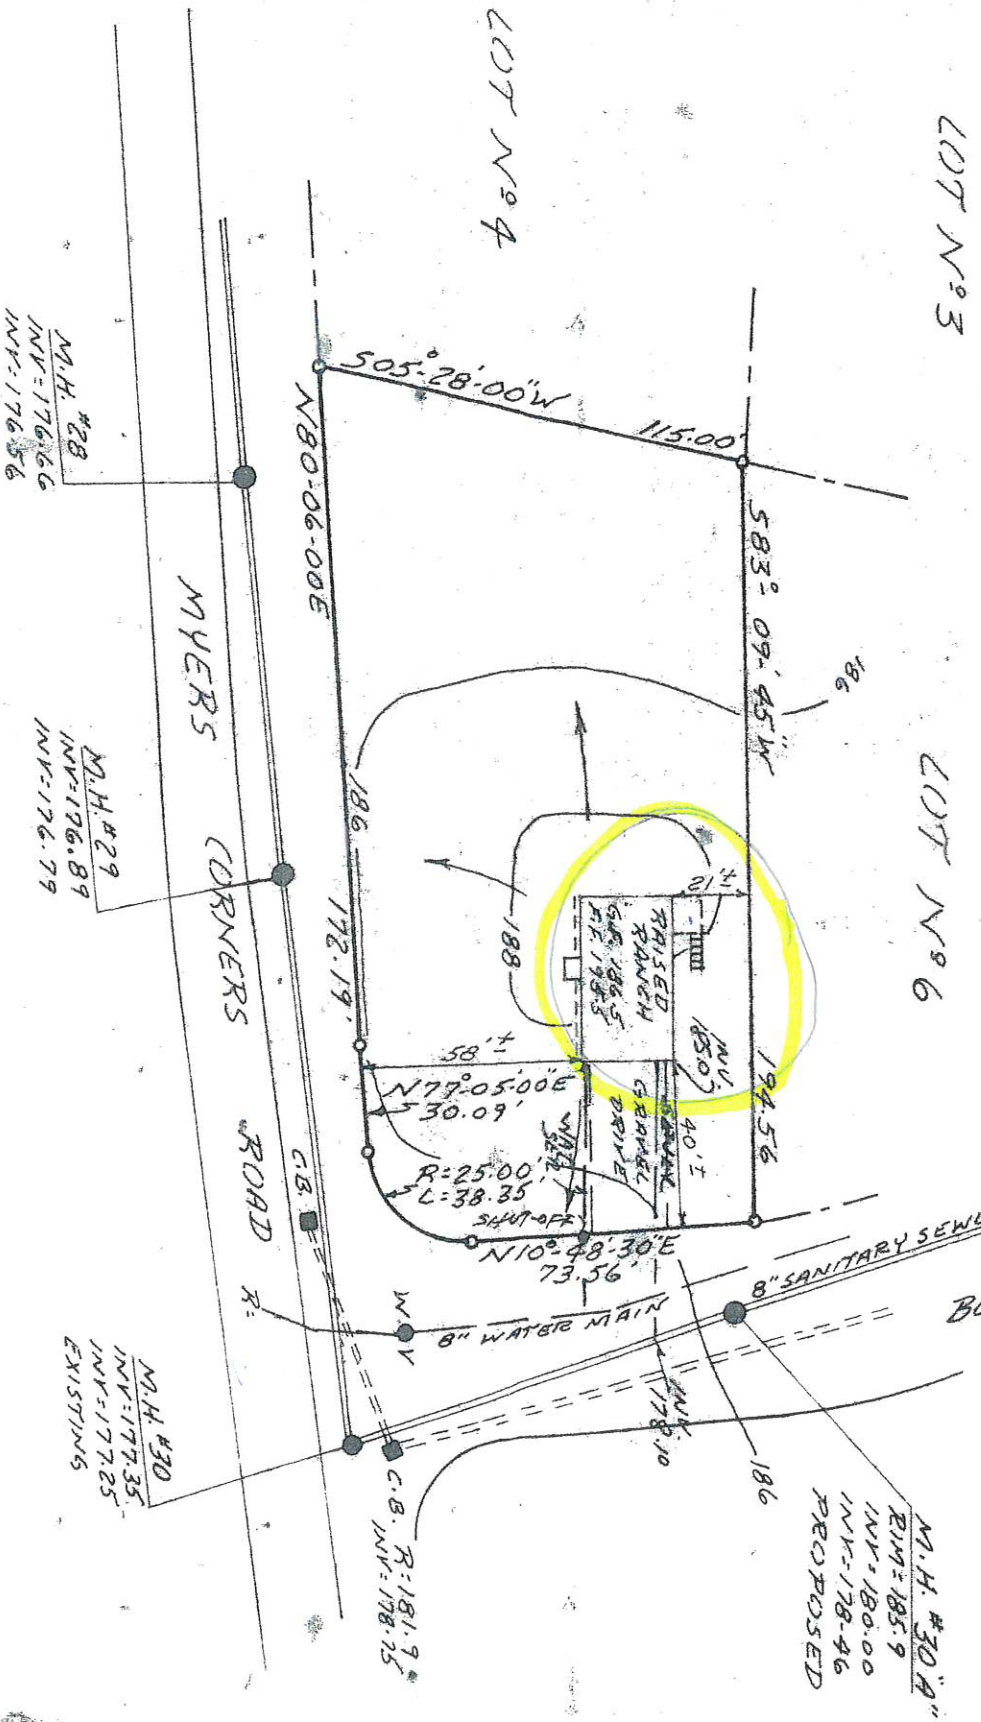

NOTES:

- 1) CONTOURS EXISTING AS OF 8/7/78
- 2) CENTRAL WATER.
- 3) CENTRAL SEWAGE.
- 4) ANY ALTERATIONS OR ADDITIONS TO THIS HOUSE, INCLUDING GUTTERS & LEAKERS, MUST CONFORM TO TOWN AND/OR HIGHWAY SPECIFICATIONS AND REQUIREMENTS.
- 5) LOT NO. 5 HAS THE RIGHT TO DISCHARGE SURFACE WATER ACROSS OTHER LOTS. REFER TO NOTE "A" FILED MAP NO. 5046.

FERTIFIED TO:

ESTER SAUNGS BANK.

AS BUILT \$

MAP OF SURVEY

FOR

LOT NO. 5

PRINCE HILL

TOWN OF WAPPINGER
SCALE: 1" = 50 FT.

DUTCHESS COUNTY, N.Y.
18 MAY, 1978
8, AUG, 1978

RECEIVED

AUG 8 1978

SHAWY DEPARTMENT
TOWN OF WAPPINGER

RICHARD G. BERGER
P.E. & L.S.
NEW HARTENSTADT ROAD
WAPPINGERS FALLS, N.Y.

R. G. Berger
BUILDING INSPECTOR
TOWN OF WAPPINGER
Town Hall
Wappingers Falls, N. Y. 12590
Tel. 297-

Nº

