


temporary approval 6/29/78,
 subject to:
 Street elevation must be
 maintained to property line
 and blacktopped.

William P. Horton
 William P. Horton
 Supt. of Highways

Lot 7
 639-38-456
 340.54

Lot 8
 N60-53-10W
 352.81

Lot 9

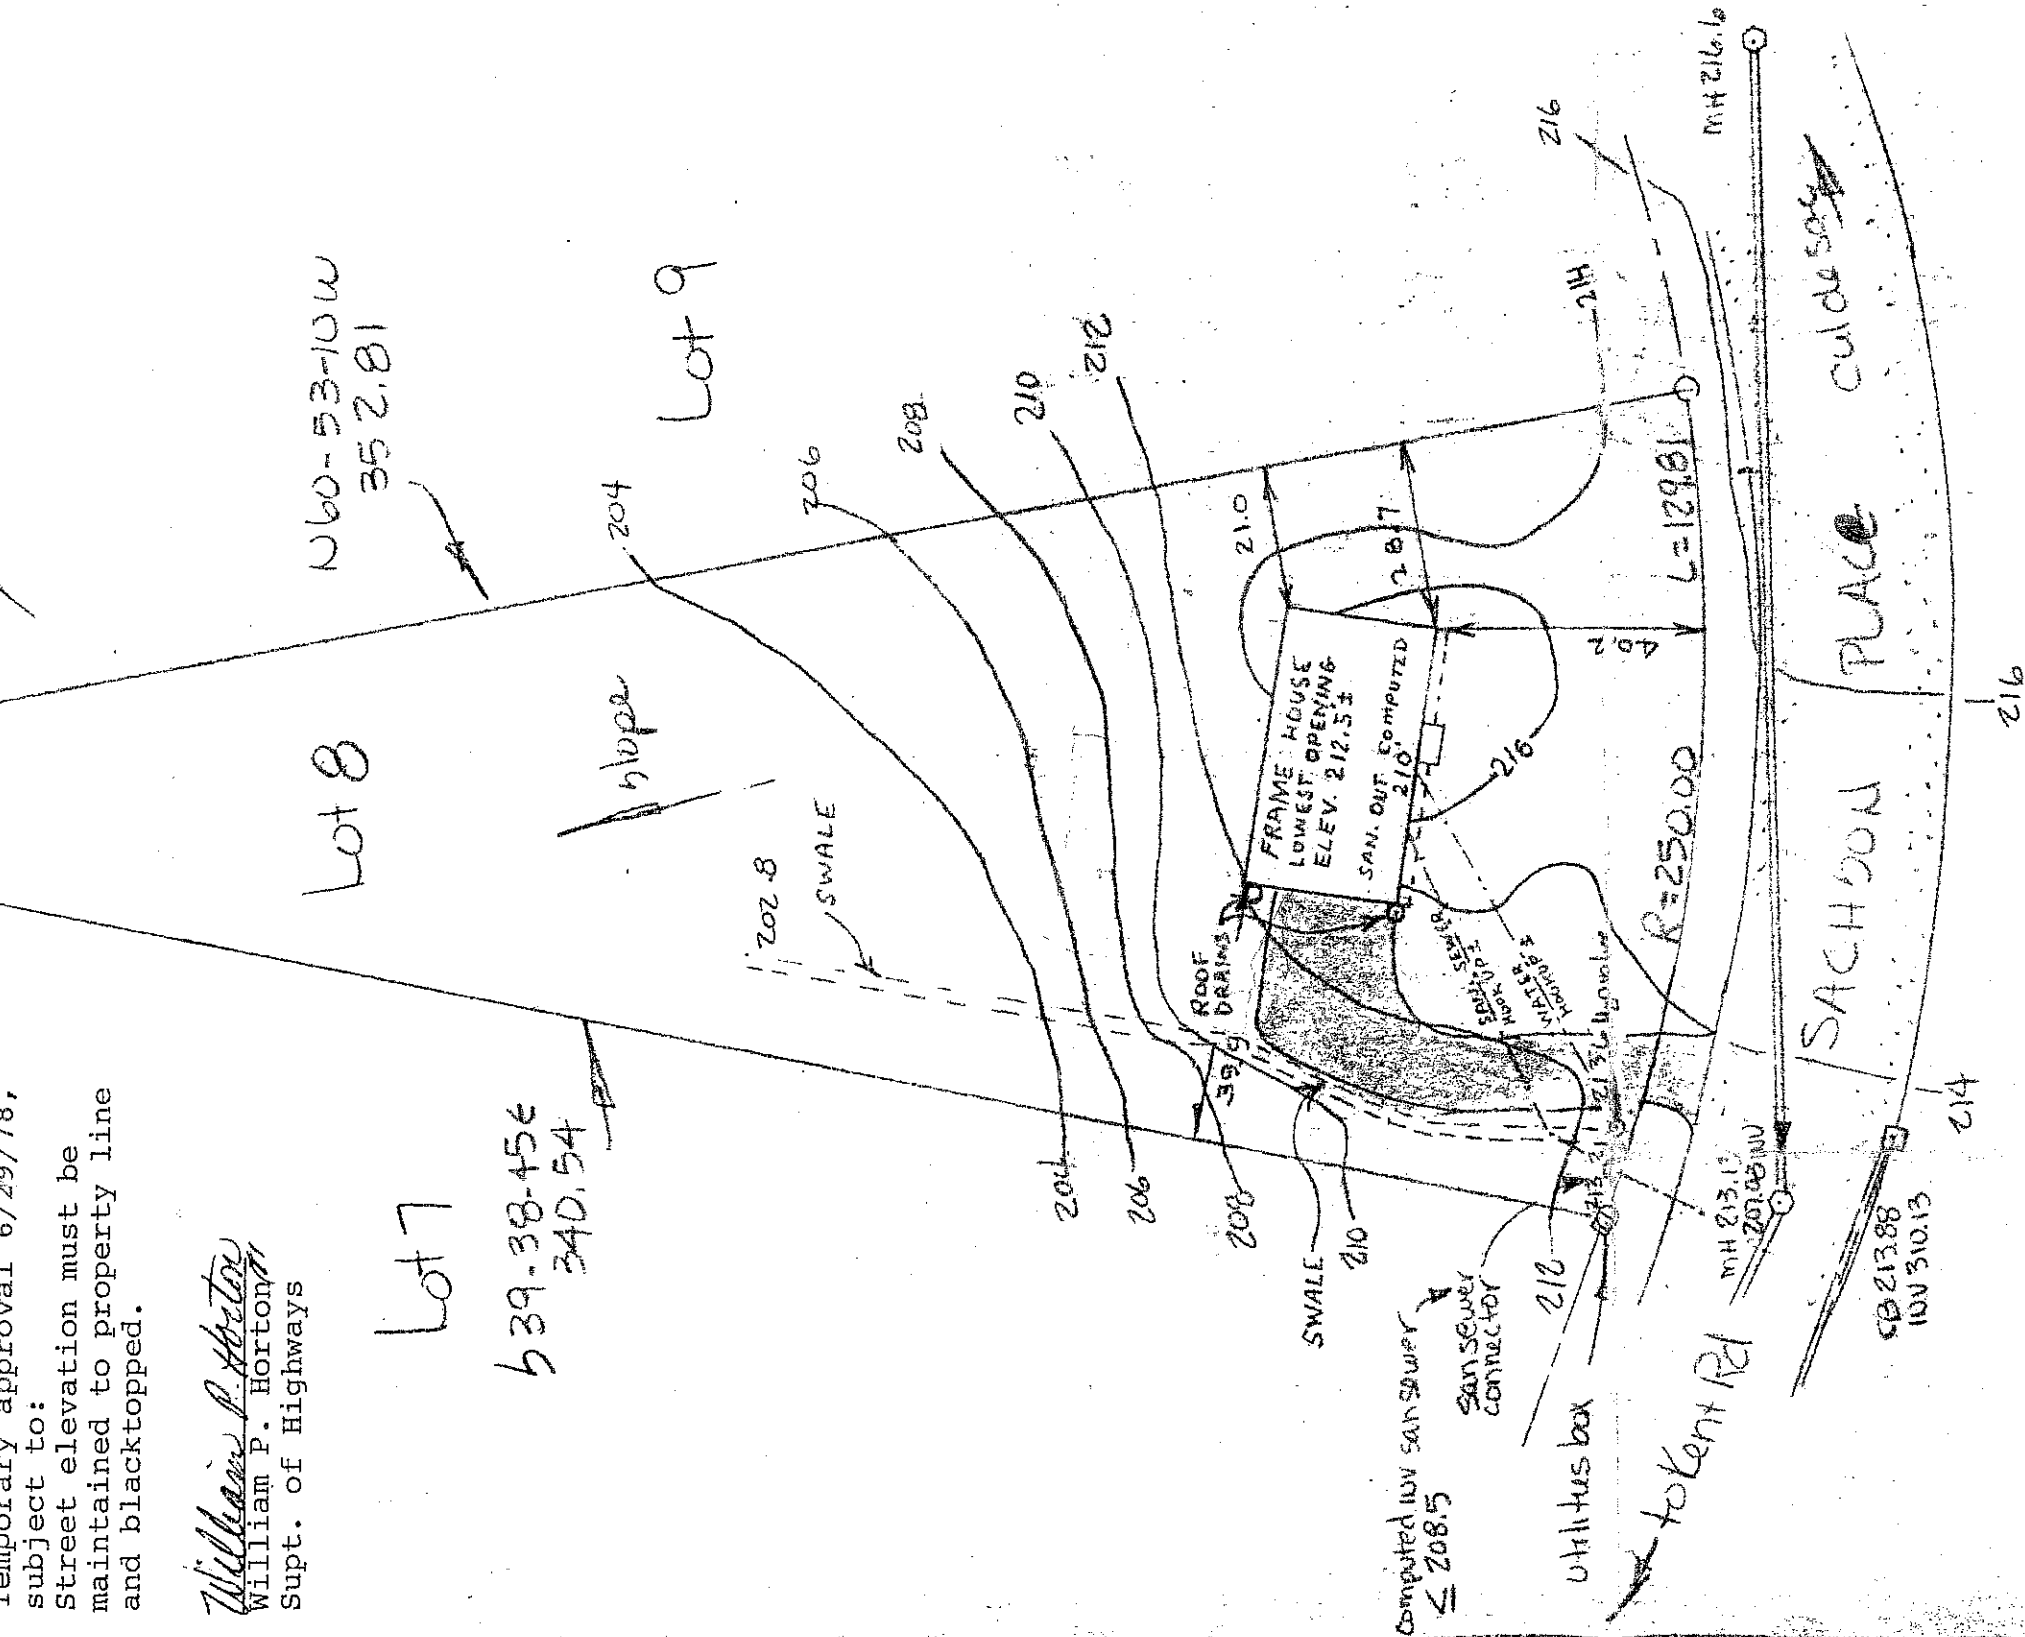

RECEIVED

JUN 28 1978

HIGHWAY DEPARTMENT
 TOWN OF WAPPINGER

H. J. Ruit
 BUILDING INSPECTOR
 TOWN OF WAPPINGER
 Town Hall
 Wappingers Falls, N. Y. 12590
 Tel. 297-

AS BUILT
 PLOT PLAN, LOT 08

KENT RIDGE, SECT 2

TOWN OF WAPPINGER

SCALE: 1" = 30'


DUTCHENS Co., NY

13 OCTOBER 1977

23 NOV 1977

JUNE 1980

RICHARD N CARLSON, 6743741 n. p. Long Branch Rd, Hopewell, NY

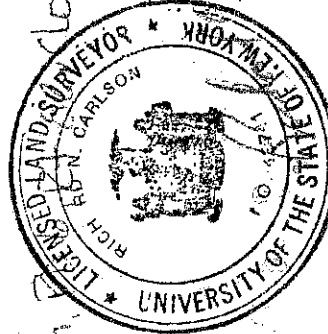

Being lots as shown on filed map
 "Kent Ridge" filed with the
 Dutchess County Clerk 17 May 1968
 map no 4835